



ATTACHMENT C

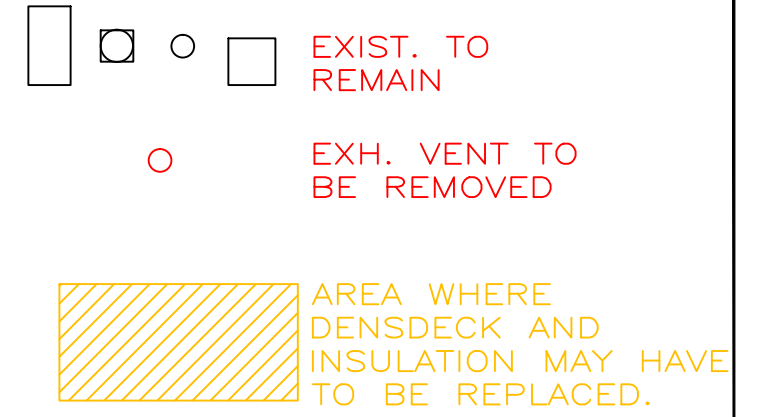

FLOOR PLAN
SCALE: 1/8"=1'-0"

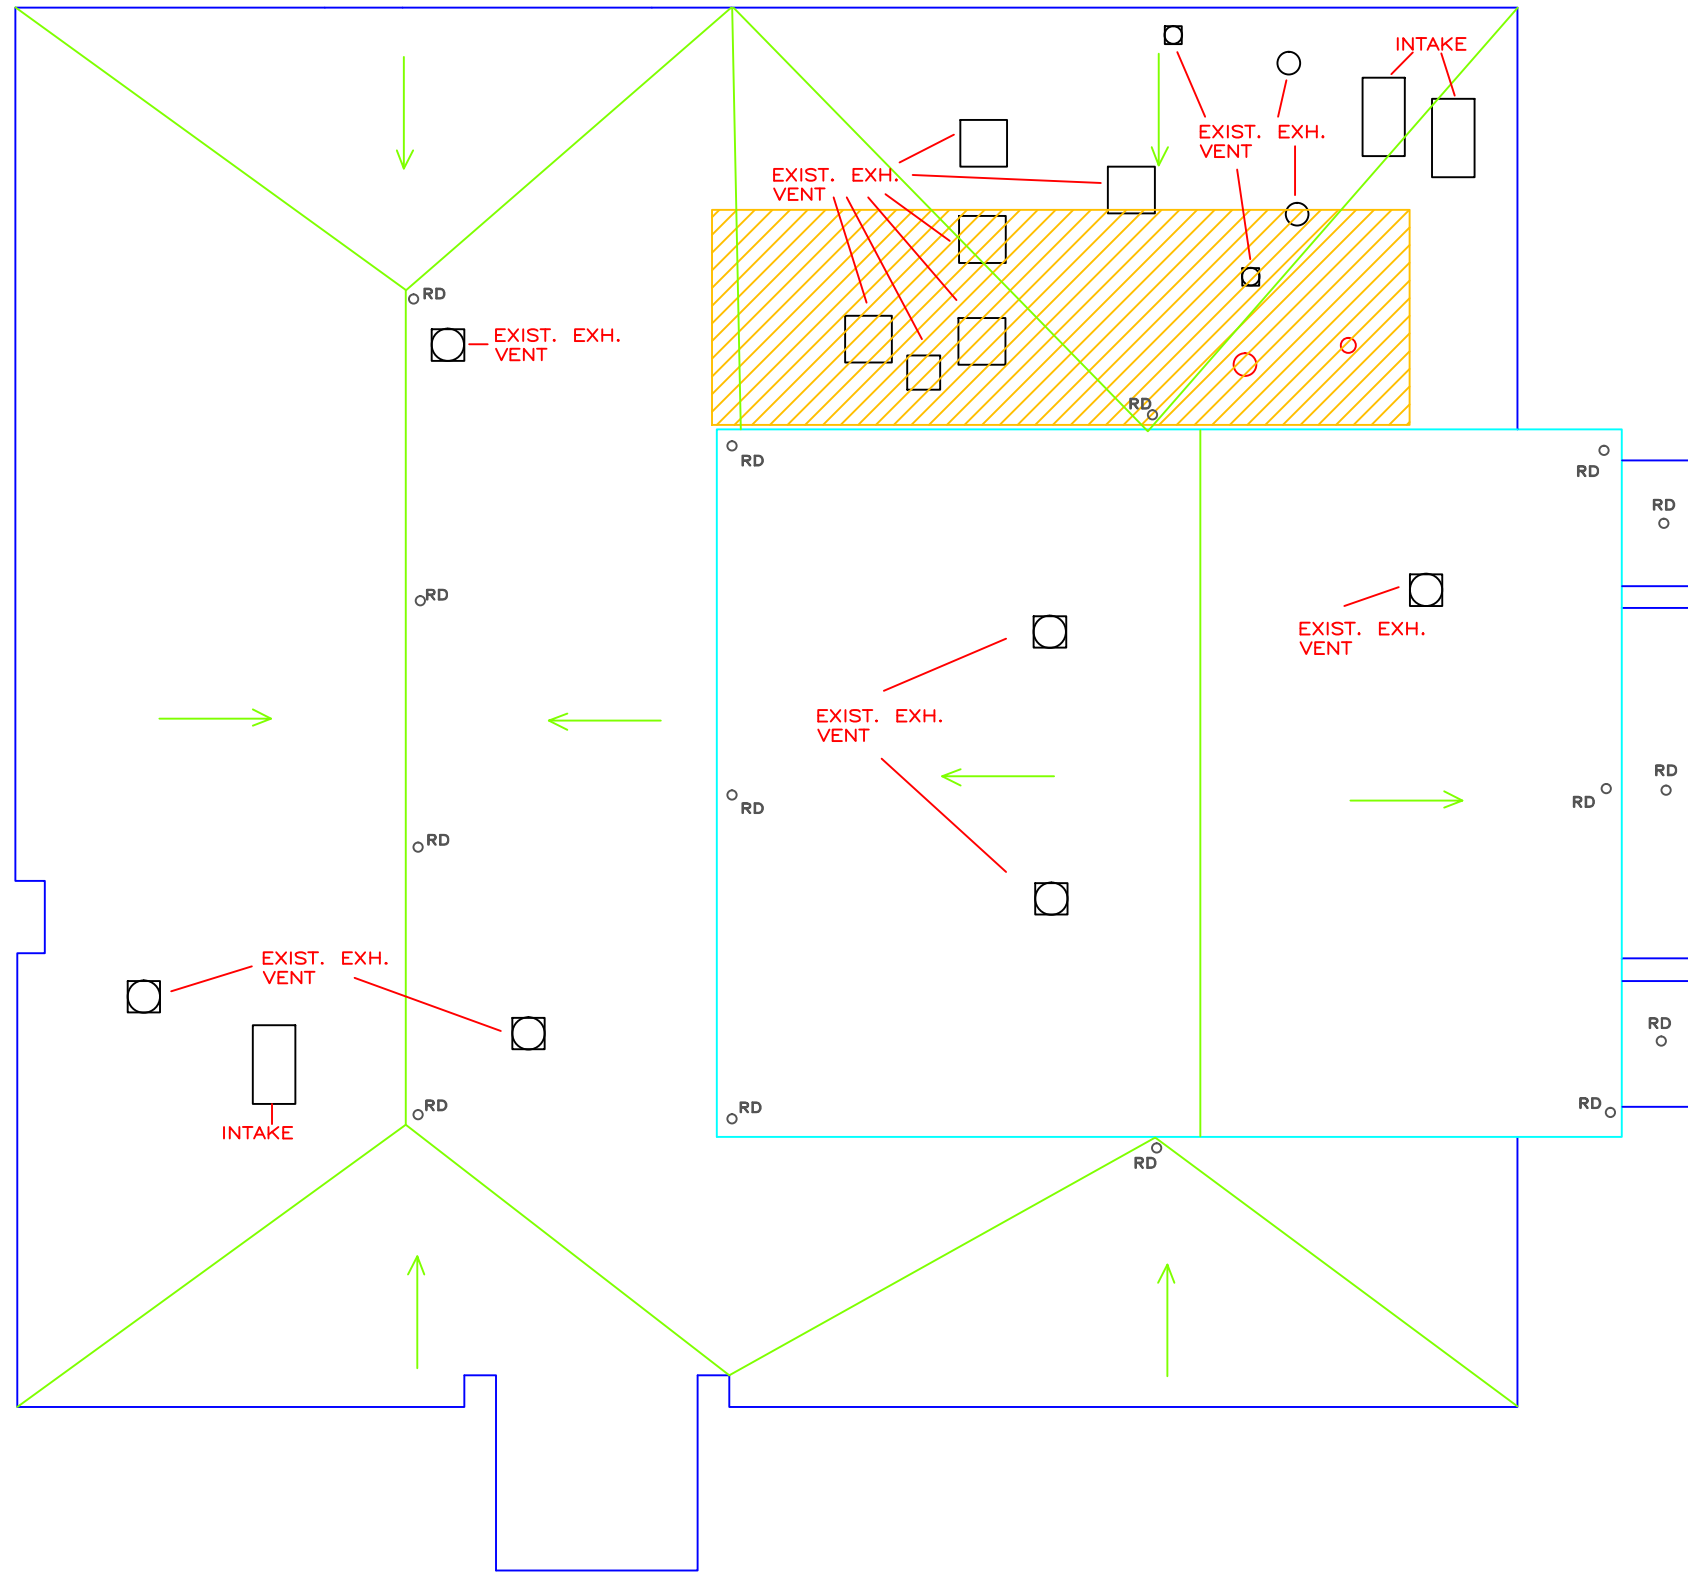

			JDT	
REESE TECHNOLOGY CENTER				
RECORD DRAWING FLOOR PLAN				
		1/8"=1'-0"		RD1130
			1	1